FED. ROAD DIV. NO.	STATE	PROJ.	FISCAL YEAR	SHEET NO.	TOTAL SHEETS
1	N.H.				

ROW VERIFIED BY ~~[illegible]~~ GEORGE DEZIEL 3/21/90

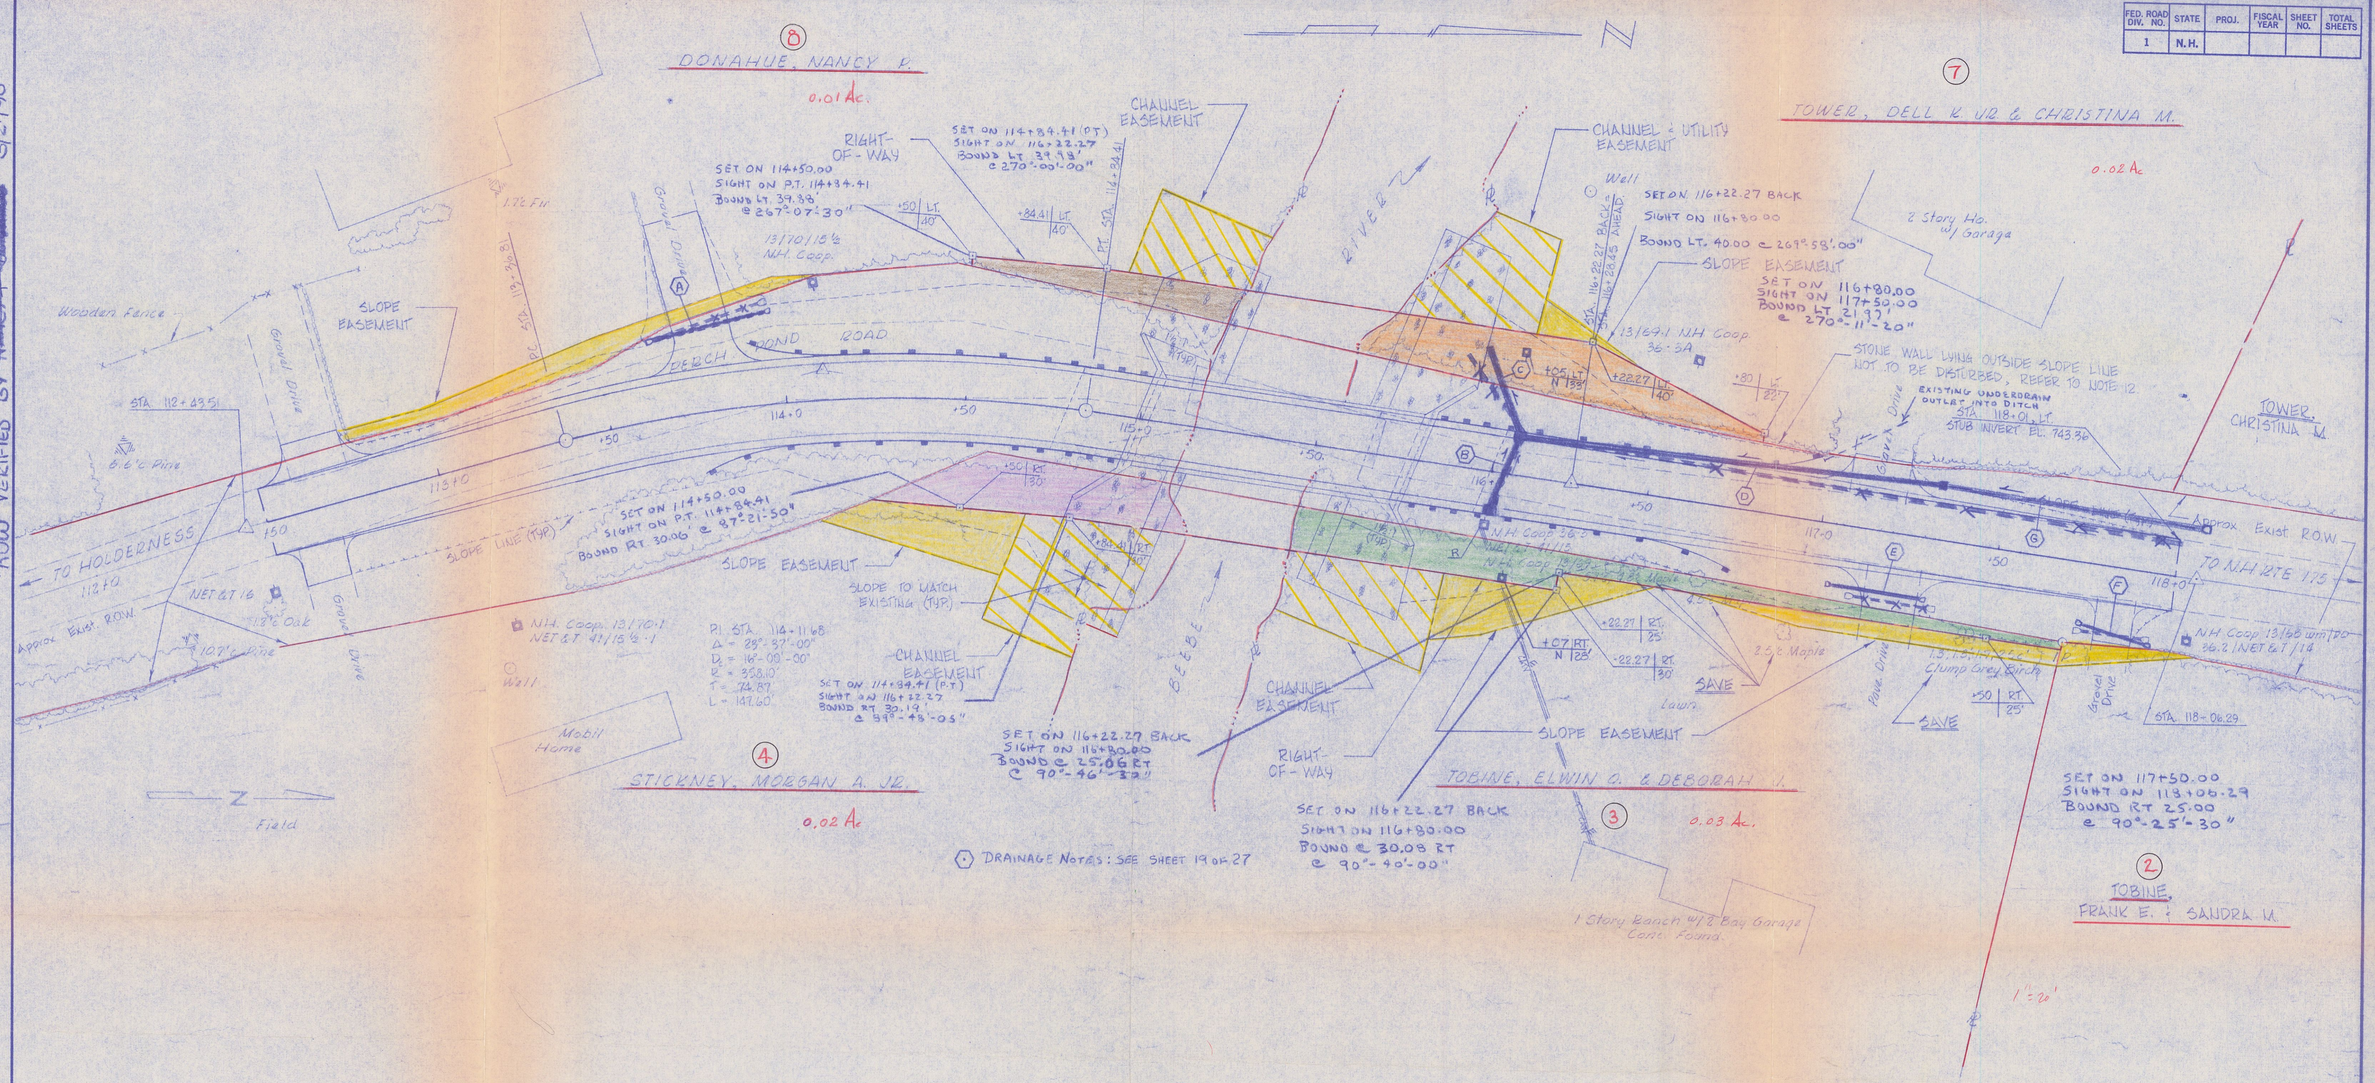

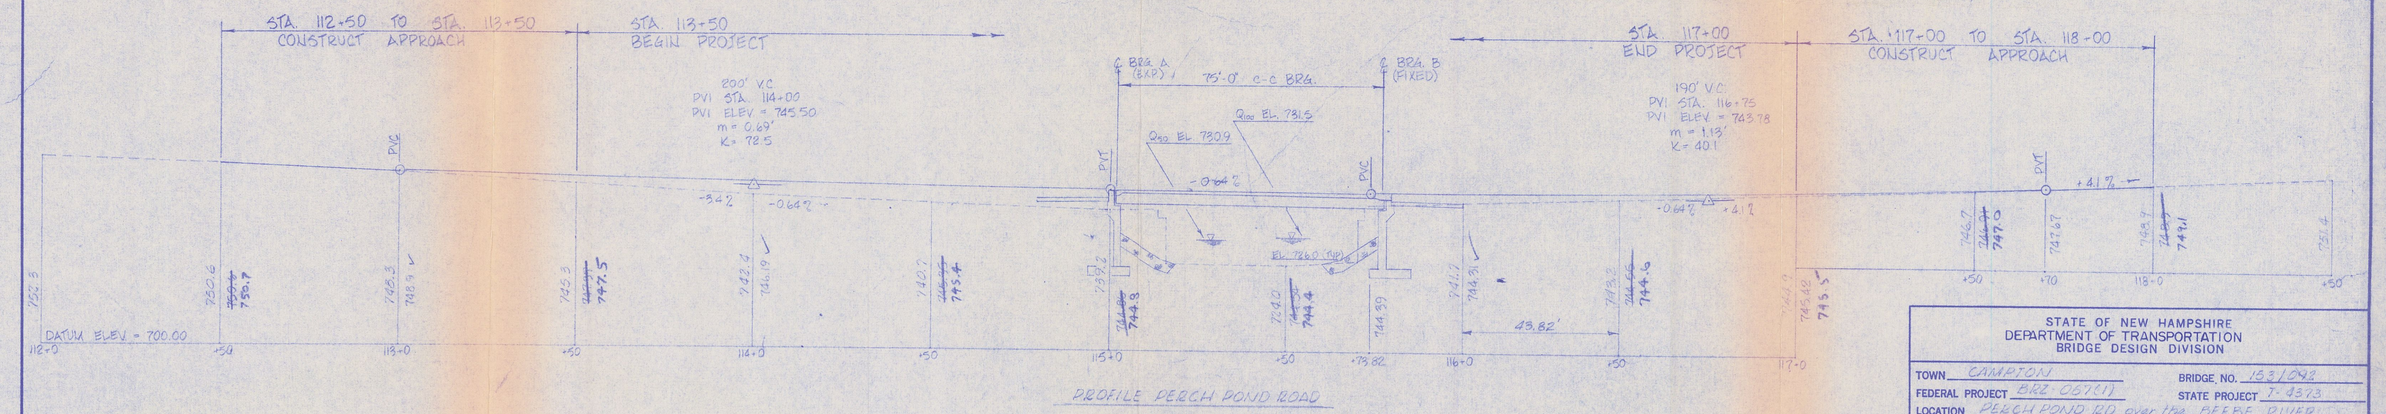

Sheet Scale 1" = 20'-0"

BOOK NO: Brands Book # 11588

△	DESCRIPTION	BY	DATE
	REVISIONS		

STATE OF NEW HAMPSHIRE
DEPARTMENT OF TRANSPORTATION
BRIDGE DESIGN DIVISION

TOWN CAMPTON — BRIDGE NO. 153/042
FEDERAL PROJECT BRZ-067(1) — STATE PROJECT 7-4373
LOCATION PERCH POND RD over the BEEBE RIVER

PLAN & PROFILE

	BY	DATE		BY	DATE
DESIGNED	RRA	2-86	CHECKED	CMW	9/86
DRAWN	GMG, CMW	7/85	CHECKED	RPW	11/86
TRACED			CHECKED		
QUANTITIES	CMW	9/86	CHECKED	JAM	3/87
REVIEWED BY					

BRIDGE SHEET NO. ___ OF ___
FILE NUMBER 6-6-3-3

PROJ. NO.	SHEET NO.	TOTAL SHEETS
BRZ-067(1)	18	27

AS BUILT PLANS

BRUNING 53232